


Ref: 18 / 05741 / Full

**SUPERSEDED**



scale 1:50 paper a3

Revisions	
Client	MR ALF
Project	1 HILARY CLOSE HAH WYCOMBE
Drawing	GROUND FLOOR
Tim Isaac Dip.Arch, MCIAT, ATP Architectural Design Services 80 Fairview Road, Taplow, Maidenhead, Berkshire SL6 0NQ Tel: 01628 628771	
Drawn	T. Isaac
Date	Ms 20.7
Scale	1:50
Drawing Number	1185/01
Revision	

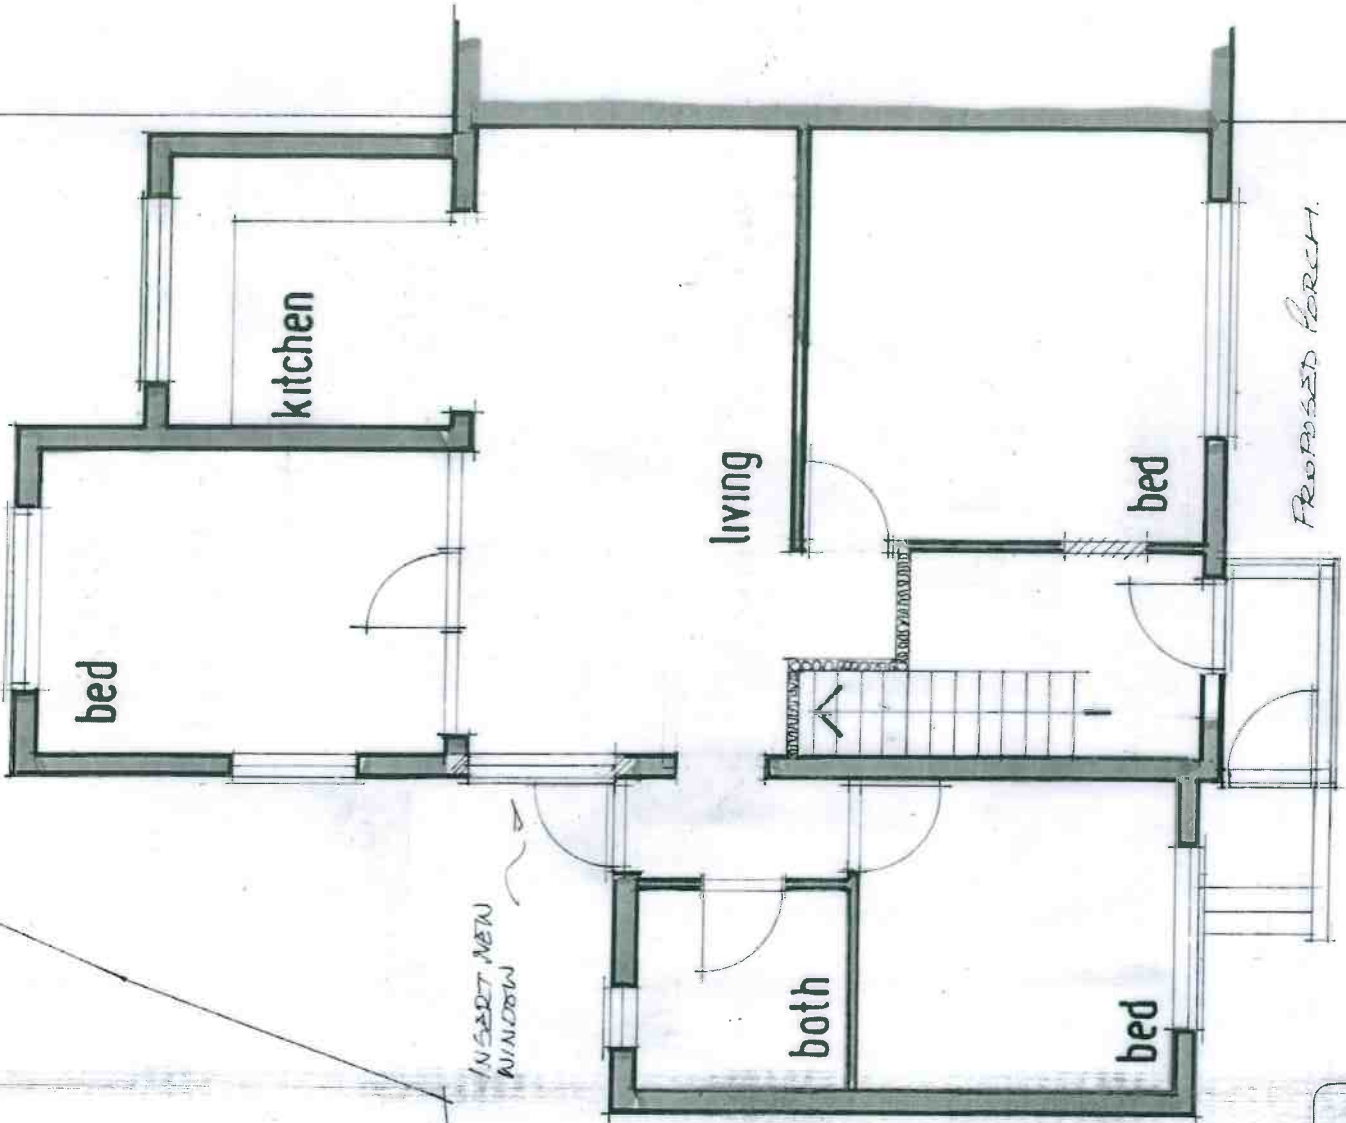


**GROUND**

Ref: 18 / 05741 / FUL  
**SUPERSEDED**




scale 1:50 paper a3


Revisions	
Client	MR. ARIF
Project	1 HILARY COOSE HEIL WYCOMBE
Drawing	FIRST FLOOR
Tim Isaac Dip. Arch, MCIAT, ATP Architectural Design Services 80 Fairview Road, Taplow, Maidenhead, Berkshire SL6 0NQ Tel: 01628 662971	
Drawn	Asaan Date 12/7/2017
Scale	1:50
Drawing Number	1185/02
Revision	

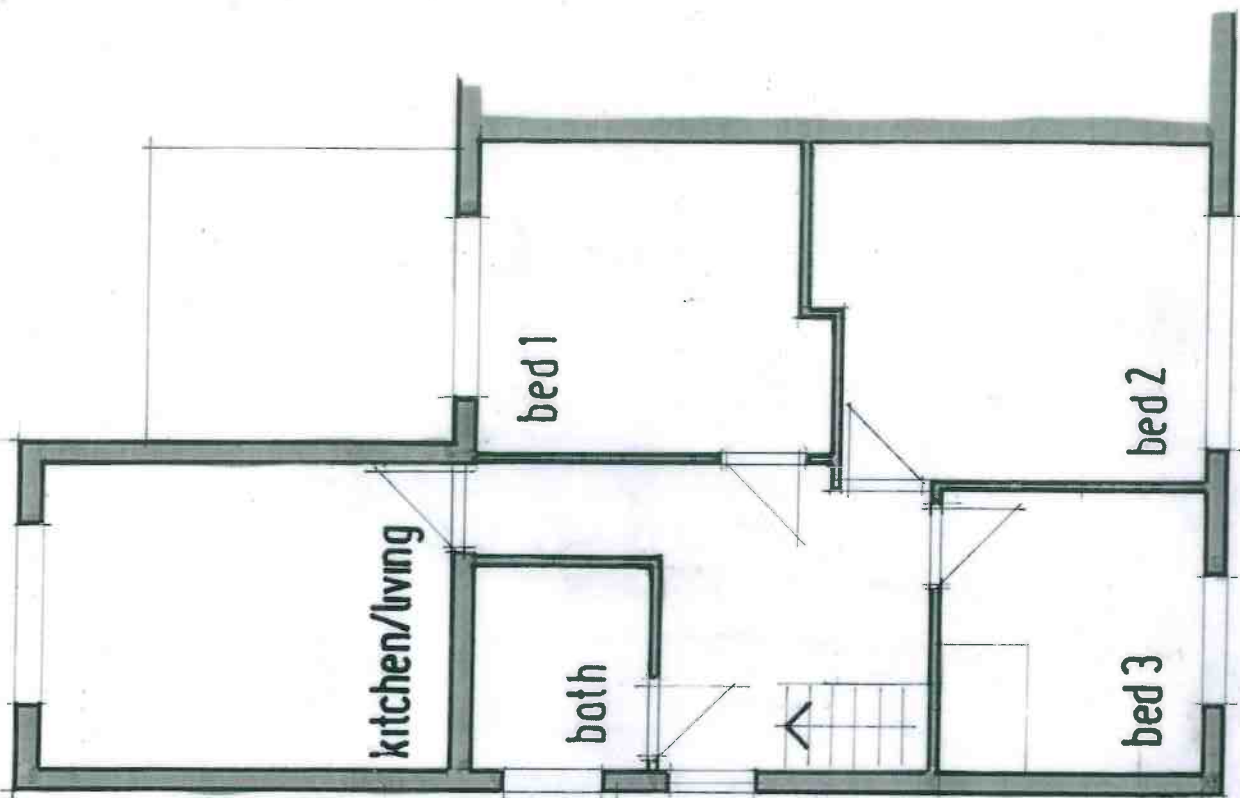


FIRST FLOOR

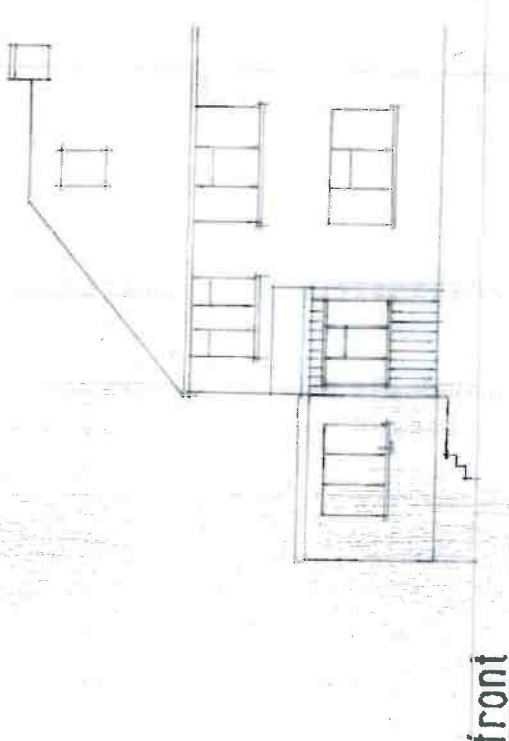

front

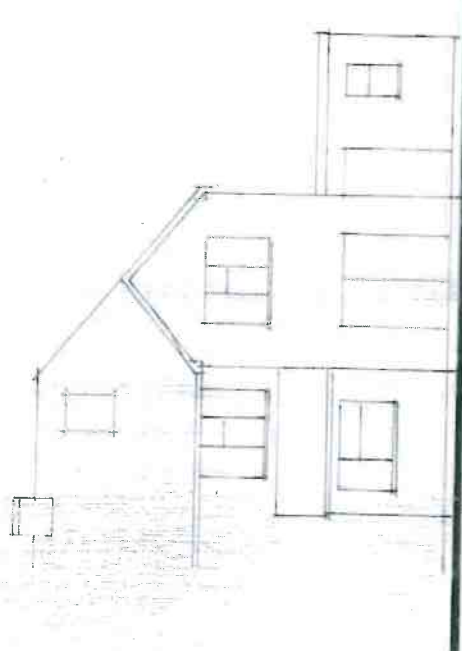

rear

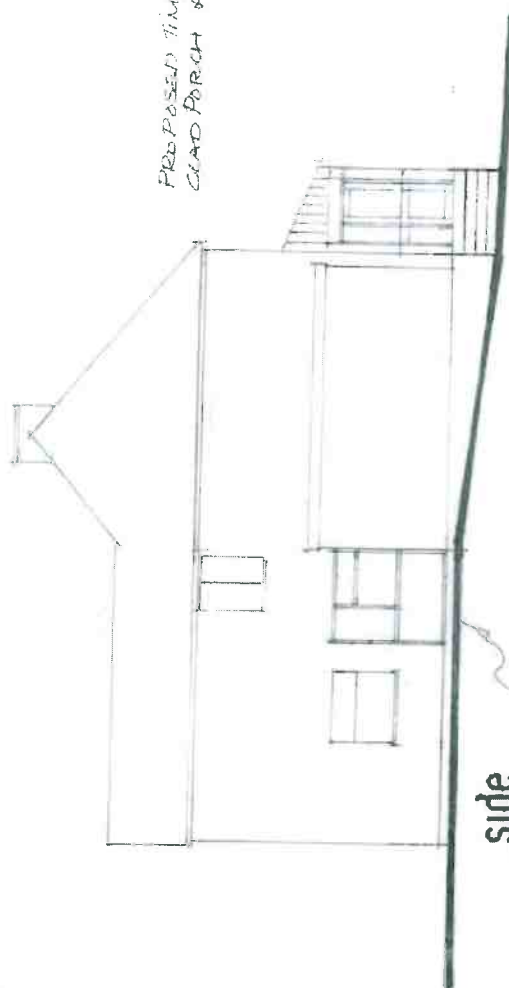

side

INSERT NEW WINDOW



scale 1:100 paper a3


Ref: 18 / 05741 / FUL  
**SUPERSEDED**

side  
 Ref: 18 / 05741 / FUL  
**AMENDED**  
 Rev A Aug 2019  
 ROLF WINDANS ARCHT.

Revisions	
Client	MR. SEIF
Project	1. HULLBY CLOSE HAA-NYCOMBE
Drawing	ELEVATIONS
Tim Isaac No. 46111, 46112, 46113, 46114 Architectural Design Services 80 Fairview Road, Toplew, Mandurah, WA 6150 Perthshire 5100 (08) 9429 6600	
Drawn	T. Isaac
Date	
Scale	1:100
Drawing Number	1185/03
Revision	0

ELEVATIONS

Ref: 18 / 05741 ..... / Full  
**SUPERSEDED**

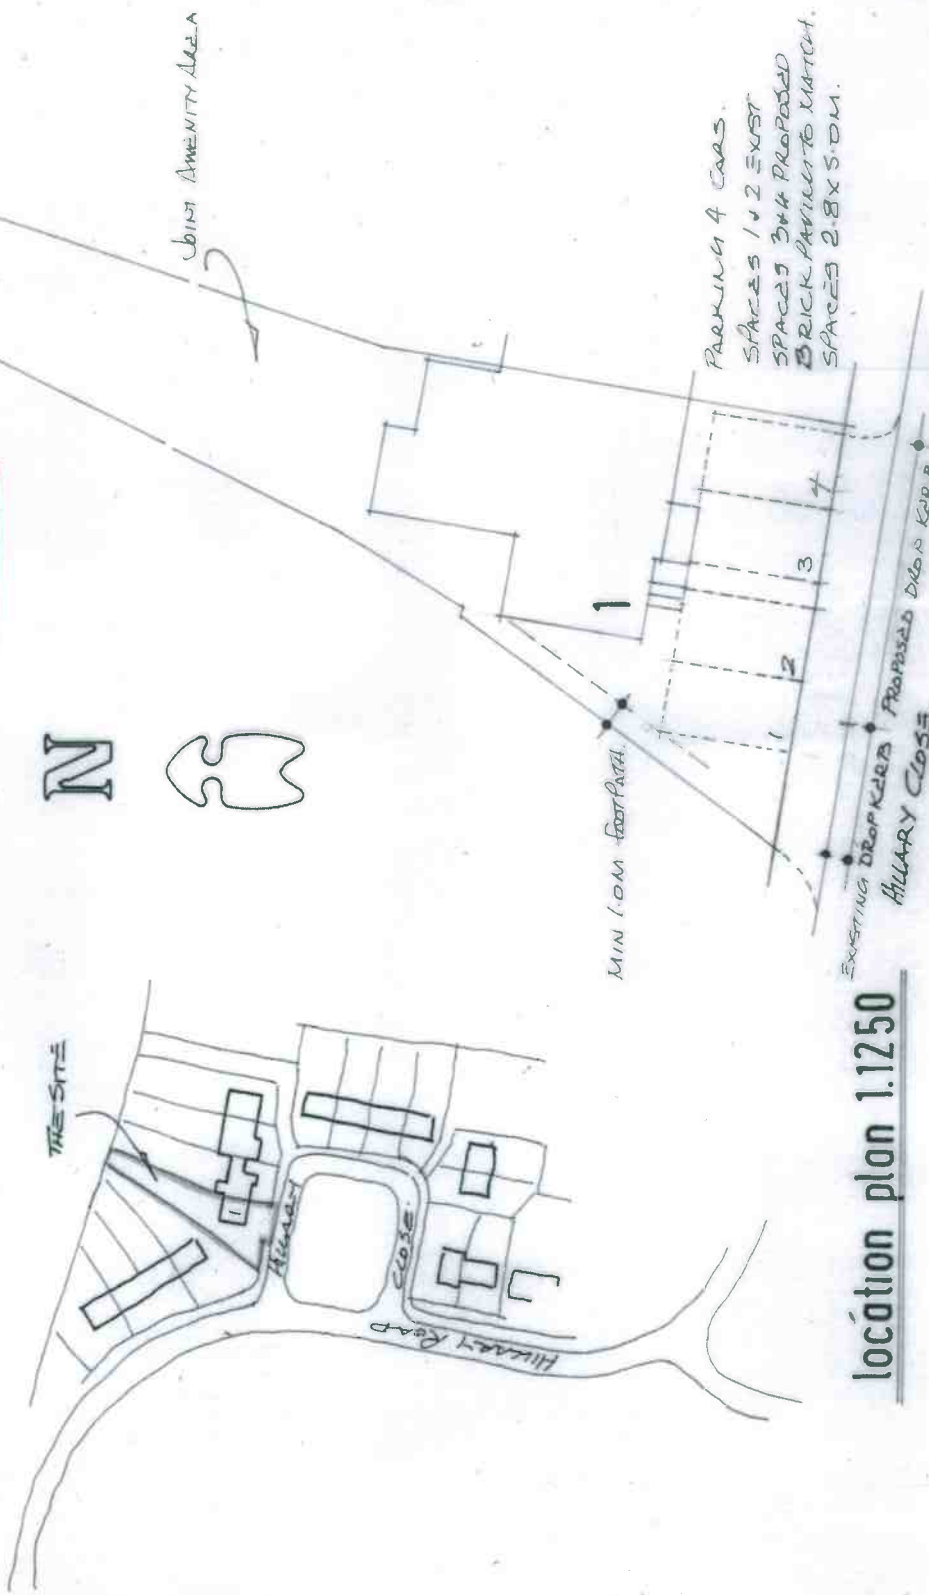

location plan 1.1250

site plan 1.200

Ref: 18 / 05741 / R  
**AMENDED**

REV A MAY 2015  
 RED LINE TO LOCATION PLAN  
 REVISED.

1	0	1	2	3

scale 150 paper a3

Revisions	
Client	MR ARIF
Project	1 HILARY CLOSE HILARY WYCOMBE
Drawing	LOCATION & SITE PLANS
Tim Isaac Dip Arch, MCIAT, ATP. Architectural Design Services 88 Fairview Road, Taplow, Maidenhead, Berkshire SL6 0NQ Tel: 01228 623971	
Drawn	ASAC
Date	
Scale	1:1250 1:200
Drawing Number	1185/06
Revision	06

# LOCATION SITE PLANS