


APPENDIX 3

PLAN AS PROPOSED : MARK UP 'I'

APPROX AREA :
Approx 2,460 sqft

COVER Nos: 76

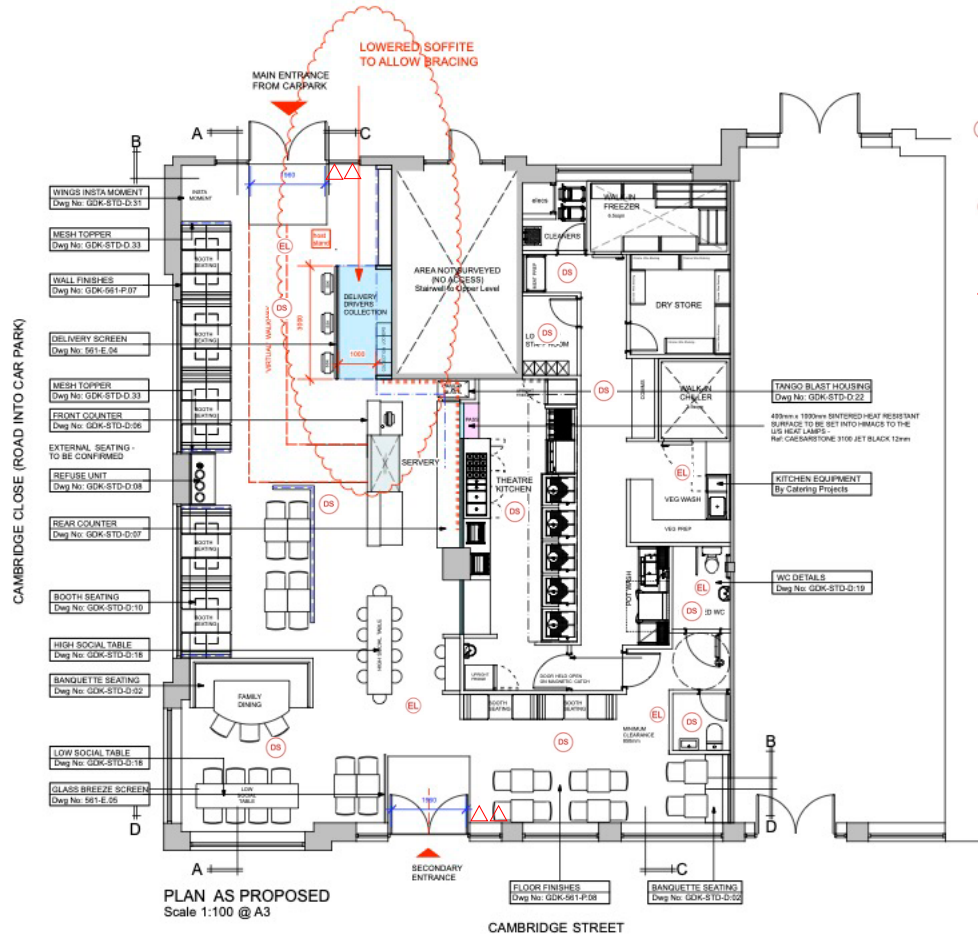

DS SMOKE DETECTOR

EL EMERGENCY LIGHTING

A FIRE EXTINGUISHERS

AYLESBURY

NOTES

DO NOT SCALE FROM THIS DRAWING.
CONTRACTORS MUST VERIFY ALL DIMENSIONS ON SITE FROM TO CONSTRUCTION PAPERS.
ANY DIMENSIONS NOT BROUGHT TO THE ATTENTION OF AN OPERATOR BECAUSE OF THE NECESSITY OF THE CONTRACTOR'S TRANSPORTATION.
THIS DRAWING IS TO BE READ IN CONJUNCTION WITH ALL THE INFORMATION AND ALL RECEIVED DRAWINGS, EXISTING SURVEYS AND SPECIALIST CONTRACTORS DRAWINGS.
THE WORKS DESCRIBED IN THIS DRAWING SHALL BE UNDERTAKEN IN ACCORDANCE WITH THE CURRENT HEALTH & SAFETY LEGISLATION AND THE HEALTH & SAFETY REGULATIONS ENFORCED BY THE ENGLAND SUPERVISOR FOR THE PROJECT.

REVISIONS

REV	DESCRIPTION	DATE
A	ISSUED FOR PERMIT	16/01/21
B	ISSUED FOR PERMIT	16/01/21
C	COOKING FLAMES - ADDITIONAL GLASS ACCESS (LAWRENCE STONE BUILDINGS)	16/01/21
D	REMAIN GLASS PANEL UNTESTED APPROVED	16/01/21
E	FREEZER AND WASH RELOCATED	16/01/21
F	DOOR WIDTHS SHOWN - ADDRESS CORRECTED	16/01/21
G	FRAMES DETACHED APPROVED	16/01/21

ol
Copyright © 2018. All rights reserved by the owner. This drawing is intended for use only for the project described. No part of this drawing may be reproduced without the written permission of the owner.
40 GLOUCESTER ROAD
LONDON W1C 2EJ
TEL: 020 700 1070

STATUS

PROJECT

AYLESBURY SHOPPING PARK
CAMBRIDGE STREET
AYLESBURY

TITLE

PLAN AS PROPOSED
MARK UP 'I'

SCALE

1:100 @ A3

DATE

NOV 20

DRAWING NO

REV

GDK-ayl-561-P-02 G

